

STATE OF UTAH
DEPARTMENT OF NATURAL RESOURCES
DIVISION OF OIL, GAS AND MINING

FORM 3

AMENDED REPORT
(highlight changes)

APPLICATION FOR PERMIT TO DRILL

RIG SKID

5 MINERAL LEASE NO
UTU-76033

6 SURFACE
Federal

1A. TYPE OF WORK: DRILL REENTER DEEPEN

7. IF INDIAN, ALLOTTEE OR TRIBE NAME:
N/A

B. TYPE OF WELL: OIL GAS OTHER _____ SINGLE ZONE MULTIPLE ZONE

8 UNIT or CA AGREEMENT NAME:
N/A

2. NAME OF OPERATOR:
Gasco Production Company

9 WELL NAME and NUMBER:
Federal 32-19x-9-19

3. ADDRESS OF OPERATOR:
8 Inverness Drive E, Sui Englewood Co 80112

PHONE NUMBER:
(303) 483-0044

10. FIELD AND POOL, OR WILDCAT:
Wildcat

4. LOCATION OF WELL (FOOTAGES)
AT SURFACE: 2050' FNL & 2137' FEL 600644X 40. 018 044
AT PROPOSED PRODUCING ZONE: SW NE 4430214Y -109. 820674

11. QTR/QTR, SECTION, TOWNSHIP, RANGE, MERIDIAN:
SWNE 19 9S 19E

14. DISTANCE IN MILES AND DIRECTION FROM NEAREST TOWN OR POST OFFICE:
Approximately 27 miles southeast of Myton, Utah

12. COUNTY: Uintah
13. STATE: UTAH

15. DISTANCE TO NEAREST PROPERTY OR LEASE LINE (FEET):
2050'

16. NUMBER OF ACRES IN LEASE:
600.00

17. NUMBER OF ACRES ASSIGNED TO THIS WELL:
40

18. DISTANCE TO NEAREST WELL (DRILLING, COMPLETED, OR APPLIED FOR) ON THIS LEASE (FEET):
None

19. PROPOSED DEPTH:
15,105

20. BOND DESCRIPTION:
Bond #UT-1233

21. ELEVATIONS (SHOW WHETHER DF, RT, GR, ETC.):
4864.6 KB; 4839.2 GL

22. APPROXIMATE DATE WORK WILL START:
4/7/2008

23. ESTIMATED DURATION:
35 days

PROPOSED CASING AND CEMENTING PROGRAM

SIZE OF HOLE	CASING SIZE, GRADE, AND WEIGHT PER FOOT	SETTING DEPTH	CEMENT TYPE, QUANTITY, YIELD, AND SLURRY WEIGHT
24"	16" H-40 65#	40	4 yards of Class G
12-1/4"	8-5/8" J-55 32#	3,535	650 sx Class G 11.0 ppg 3.89 yield 260 sx Class G tail 14.2 ppg 1.65 yield
7-7/8"	4-1/2" P110 15.1#	15,105	1190 sx of Class G 12.5 ppg 2.22 yield 1290 sx of Class G tail 14.1 ppg 1.535 yield

ATTACHMENTS

VERIFY THE FOLLOWING ARE ATTACHED IN ACCORDANCE WITH THE UTAH OIL AND GAS CONSERVATION GENERAL RULES:

- WELL PLAT OR MAP PREPARED BY LICENSED SURVEYOR OR ENGINEER
- EVIDENCE OF DIVISION OF WATER RIGHTS APPROVAL FOR USE OF WATER

- COMPLETE DRILLING PLAN
- FORM 5, IF OPERATOR IS PERSON OR COMPANY OTHER THAN THE LEASE OWNER

RIG SKID

NAME (PLEASE PRINT) Beverly Walker

TITLE Engineering Technician

SIGNATURE *Beverly Walker*

DATE 6/26/2008

**Approved by the
Utah Division of
Oil, Gas and Mining**

RECEIVED

API NUMBER ASSIGNED: 43047-40233

Federal Approval of this
Action is Necessary

APPROVAL:
Date: 07-21-08


JUL 18 2008
DIV. OF OIL, GAS & MINING

By: *[Signature]*

(See Instructions on Reverse Side)

R
R
18
19
E
E

T9S, R19E, S.L.B.&M.

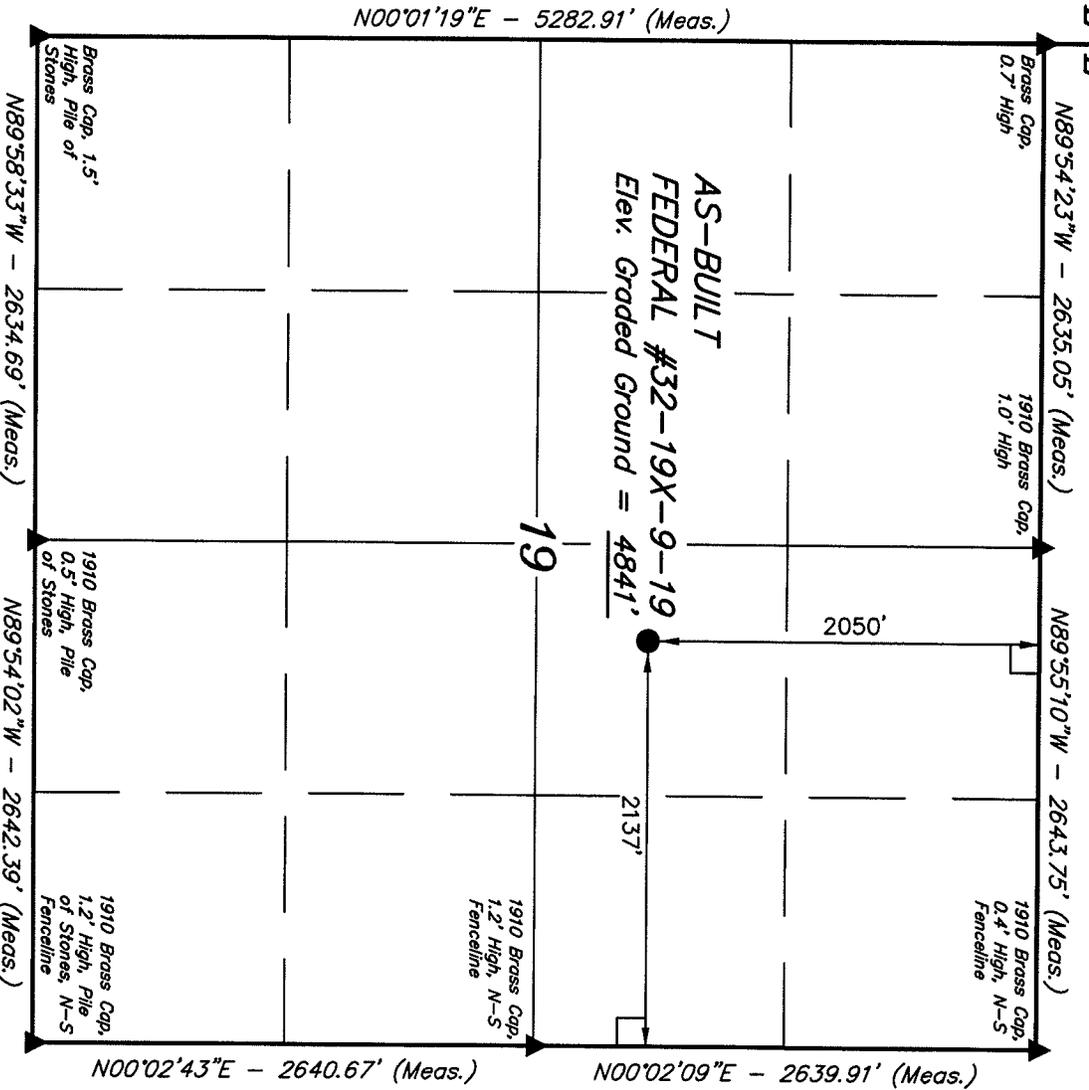

- LEGEND:**
- = 90° SYMBOL
 - = PROPOSED WELL HEAD.
 - ▲ = SECTION CORNERS LOCATED.


(AUTONOMOUS NAD 83)
 LATITUDE = 40°01'04.92" (40.018033)
 LONGITUDE = 109°49'16.97" (109.821381)
 (AUTONOMOUS NAD 27)
 LATITUDE = 40°01'05.05" (40.018069)
 LONGITUDE = 109°49'14.46" (109.820683)

GASCO PRODUCTION COMPANY


Well location, AS-BUILT FEDERAL #32-19X-9-19, located as shown in the SW 1/4 NE 1/4 of Section 19, T9S, R19E, S.L.B.&M., Uintah County, Utah.

BASIS OF ELEVATION
 SPOT ELEVATION LOCATED AT THE NORTHEAST CORNER OF SECTION 21, T9S, R19E, S.L.B.&M. TAKEN FROM THE UTELAND BUTTE, QUADRANGLE, UTAH, UINAH COUNTY, 7.5 MINUTE QUAD. (TOPOGRAPHIC MAP) PUBLISHED BY THE UNITED STATES DEPARTMENT OF THE INTERIOR, GEOLOGICAL SURVEY. SAID ELEVATION IS MARKED AS BEING 4711 FEET.

BASIS OF BEARINGS
 BASIS OF BEARINGS IS A G.P.S. OBSERVATION.

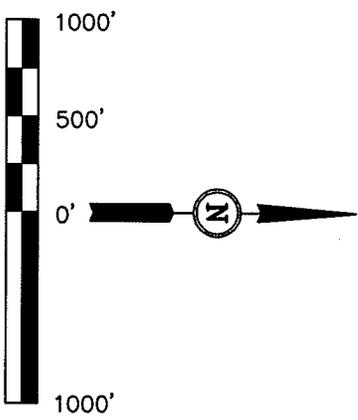

CERTIFICATE
 THIS IS TO CERTIFY THAT THE ABOVE PLANS AND PREPARED FROM FIELD NOTES OF ACTUAL SURVEYS MADE BY ME AND CORRECTED TO THE BEST OF MY KNOWLEDGE AND BELIEF.

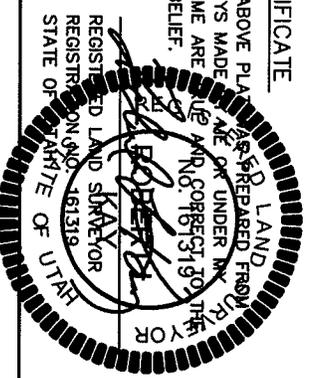

UINTAH ENGINEERING & LAND SURVEYING
 86 SOUTH 200 EAST - VERNAL, UTAH 84078
 (435) 789-1017

SCALE	1" = 1000'	DATE SURVEYED:	05-29-08	DATE DRAWN:	06-09-08
PARTY	J.W. C.G. C.H.	REFERENCES	G.L.O. PLAT		
WEATHER	WARM	FILE	GASCO PRODUCTION COMPANY		