**STATE OF UTAH**
DEPARTMENT OF NATURAL RESOURCES
DIVISION OF OIL, GAS AND MINING

FORM 3

AMENDED REPORT ☐
(highlight changes)

# APPLICATION FOR PERMIT TO DRILL

5. MINERAL LEASE NO: ML-46694
6. SURFACE: State

1A. TYPE OF WORK: DRILL ☑ REENTER ☐ DEEPEN ☐

7. IF INDIAN, ALLOTTEE OR TRIBE NAME: NA

B. TYPE OF WELL: OIL ☑ GAS ☐ OTHER _____ SINGLE ZONE ☑ MULTIPLE ZONE ☐

8. UNIT or CA AGREEMENT NAME: Beluga

2. NAME OF OPERATOR: Newfield Production Company

9. WELL NAME and NUMBER: Beluga State Q-16-9-17

3. ADDRESS OF OPERATOR: Route #3 Box 3630 CITY Myton STATE UT ZIP 84052
PHONE NUMBER: (435) 646-3721

10. FIELD AND POOL, OR WILDCAT: Monument Butte

4. LOCATION OF WELL (FOOTAGES) 584198 X 4431221 Y 40.029263 -110.013221
AT SURFACE: NE/SW 1987' FSL 1971' FWL
AT PROPOSED PRODUCING ZONE: 1290' FSL 1300' FWL
583995 X 4431046 Y 40.027338 -110.015635

11. QTR/QTR, SECTION, TOWNSHIP, RANGE, MERIDIAN: NESW 16 9S 17E

14. DISTANCE IN MILES AND DIRECTION FROM NEAREST TOWN OR POST OFFICE: Approximately 15.5 miles southeast of Myton, Utah

12. COUNTY: Duchesne
13. STATE: UTAH

15. DISTANCE TO NEAREST PROPERTY OR LEASE LINE (FEET): Approx, 20' f/lse line, 1290' f/unit line

16. NUMBER OF ACRES IN LEASE: 40.00 acres

17. NUMBER OF ACRES ASSIGNED TO THIS WELL: 20 acres

18. DISTANCE TO NEAREST WELL (DRILLING, COMPLETED, OR APPLIED FOR) ON THIS LEASE (FEET): Approx. 1370'

19. PROPOSED DEPTH: 5840 ~~5,723~~

20. BOND DESCRIPTION: Hartford Accident #4471291

21. ELEVATIONS (SHOW WHETHER DF, RT, GR, ETC.): 5291' GL

22. APPROXIMATE DATE WORK WILL START: 1st Qrtr. 2009

23. ESTIMATED DURATION: (7) days from SPUD to rig release

24. **PROPOSED CASING AND CEMENTING PROGRAM**

| SIZE OF HOLE | CASING SIZE, GRADE, AND WEIGHT PER FOOT | | | SETTING DEPTH | CEMENT TYPE, QUANTITY, YIELD, AND SLURRY WEIGHT | | | |
|---|---|---|---|---|---|---|---|---|
| 12 1/4 | 8 5/8 | J-55 | 24.0 | 300 | Class G w/2% CaCl | 155 sx +/- | 1.17 | 15.8 |
| 7 7/8 | 5 1/2 | J-55 | 15.5 | 5840 ~~5,723~~ | Lead(Prem Lite II) | 275 sx +/- | 3.26 | 11.0 |
| | | | | | Tail (50/50 Poz) | 450 sx +/- | 1.24 | 14.3 |
| | | | | | | | | |
| | | | | | | | | |
| | | | | | | | | |
| | | | | | | | | |

25. **ATTACHMENTS**

VERIFY THE FOLLOWING ARE ATTACHED IN ACCORDANCE WITH THE UTAH OIL AND GAS CONSERVATION GENERAL RULES:

☑ WELL PLAT OR MAP PREPARED BY LICENSED SURVEYOR OR ENGINEER
☑ EVIDENCE OF DIVISION OF WATER RIGHTS APPROVAL FOR USE OF WATER
☑ COMPLETE DRILLING PLAN
☐ FORM 5, IF OPERATOR IS PERSON OR COMPANY OTHER THAN THE LEASE OWNER

NAME (PLEASE PRINT) Mandie Crozier TITLE Regulatory Specialist

SIGNATURE Mandie Crozier DATE 11/20/08

(This space for State use only)

API NUMBER ASSIGNED: 43-013-34448

Approved by the
Utah Division of
Oil, Gas and Mining

APPROVAL:

Date: 02-05-09
(See Instructions on Reverse Side)
By: [signature]

RECEIVED
NOV 24 2008
DIV. OF OIL, GAS & MINING

(11/2001)

# T9S, R17E, S.L.B.&M.

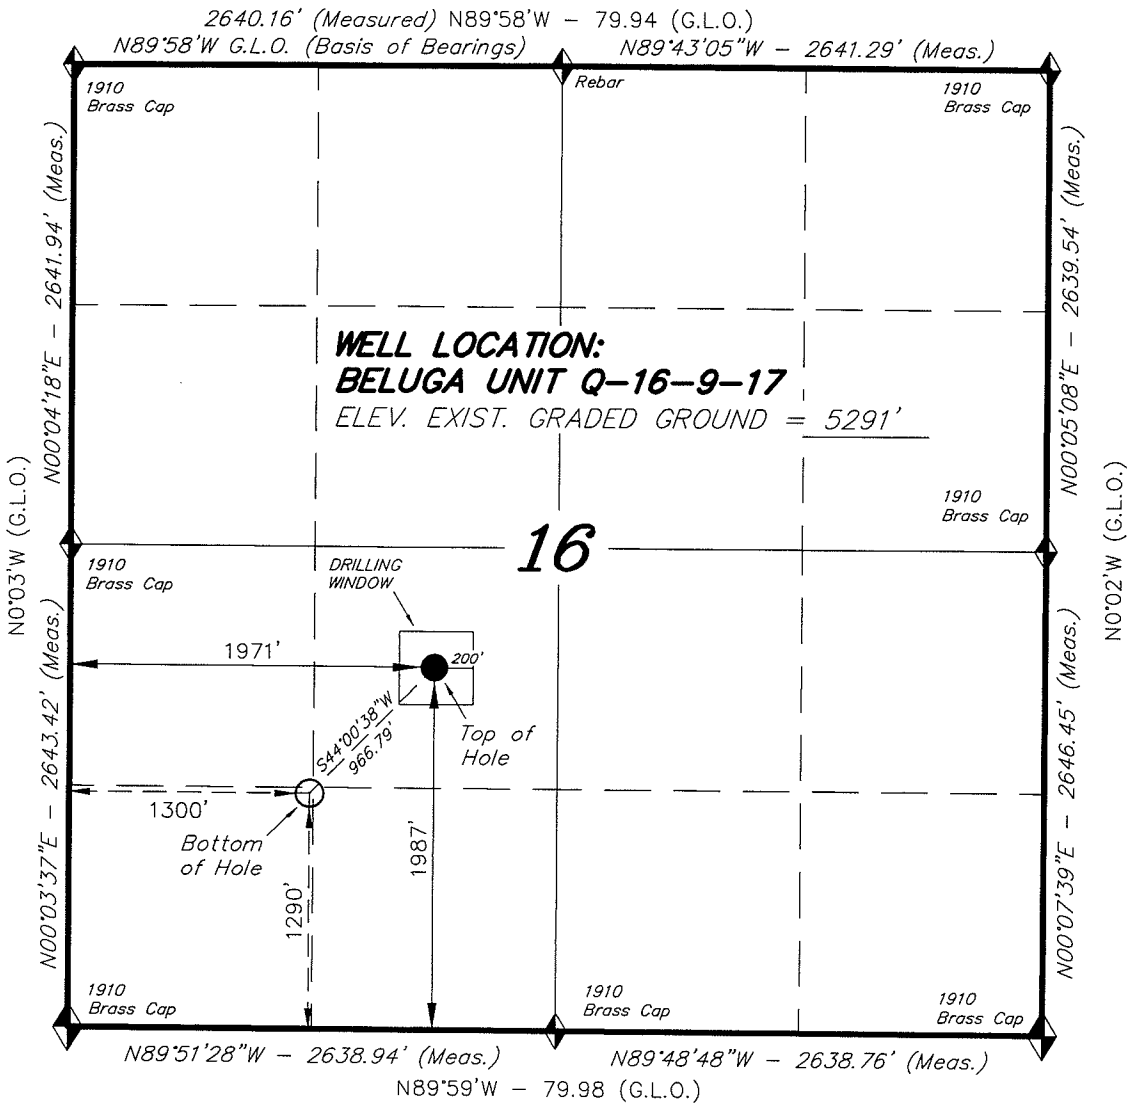


## NEWFIELD PRODUCTION COMPANY

WELL LOCATION, BELUGA UNIT Q-16-9-17, LOCATED AS SHOWN IN THE NE 1/4 SW 1/4 OF SECTION 16, T9S, R17E, S.L.B.&M. DUCHESNE COUNTY, UTAH.

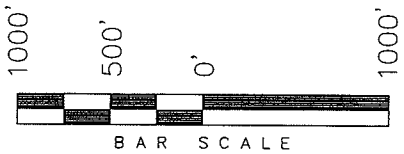

THIS IS TO CERTIFY THAT THE ABOVE PLAT WAS PREPARED FROM FIELD NOTES OF ACTUAL SURVEYS MADE BY ME OR UNDER MY SUPERVISION AND THAT THE SAME ARE TRUE AND CORRECT TO THE BEST OF MY KNOWLEDGE AND BELIEF.

REGISTERED LAND SURVEYOR No.189377 STATE OF UTAH

STACY W. STEWART
REGISTERED LAND SURVEYOR
REGISTRATION No. 189377
STATE OF UTAH

◆ = SECTION CORNERS LOCATED

BASIS OF ELEV;
U.S.G.S. 7-1/2 min QUAD (MYTON SE)

**BELUGA UNIT Q-16-9-17**
**(Surface Location) NAD 83**
LATITUDE = 40° 01' 44.97"
LONGITUDE = 110° 00' 50.35"

**TRI STATE LAND SURVEYING & CONSULTING**
180 NORTH VERNAL AVE. – VERNAL, UTAH 84078
(435) 781-2501

| | |
|---|---|
| DATE SURVEYED: 10-14-08 | SURVEYED BY: T.C. |
| DATE DRAWN: 10-15-08 | DRAWN BY: F.T.M. |
| REVISED: | SCALE: 1" = 1000' |